


88°39'59"E
99.96' L 12
WD=6.90

BIRC
PLAT

DETAIL

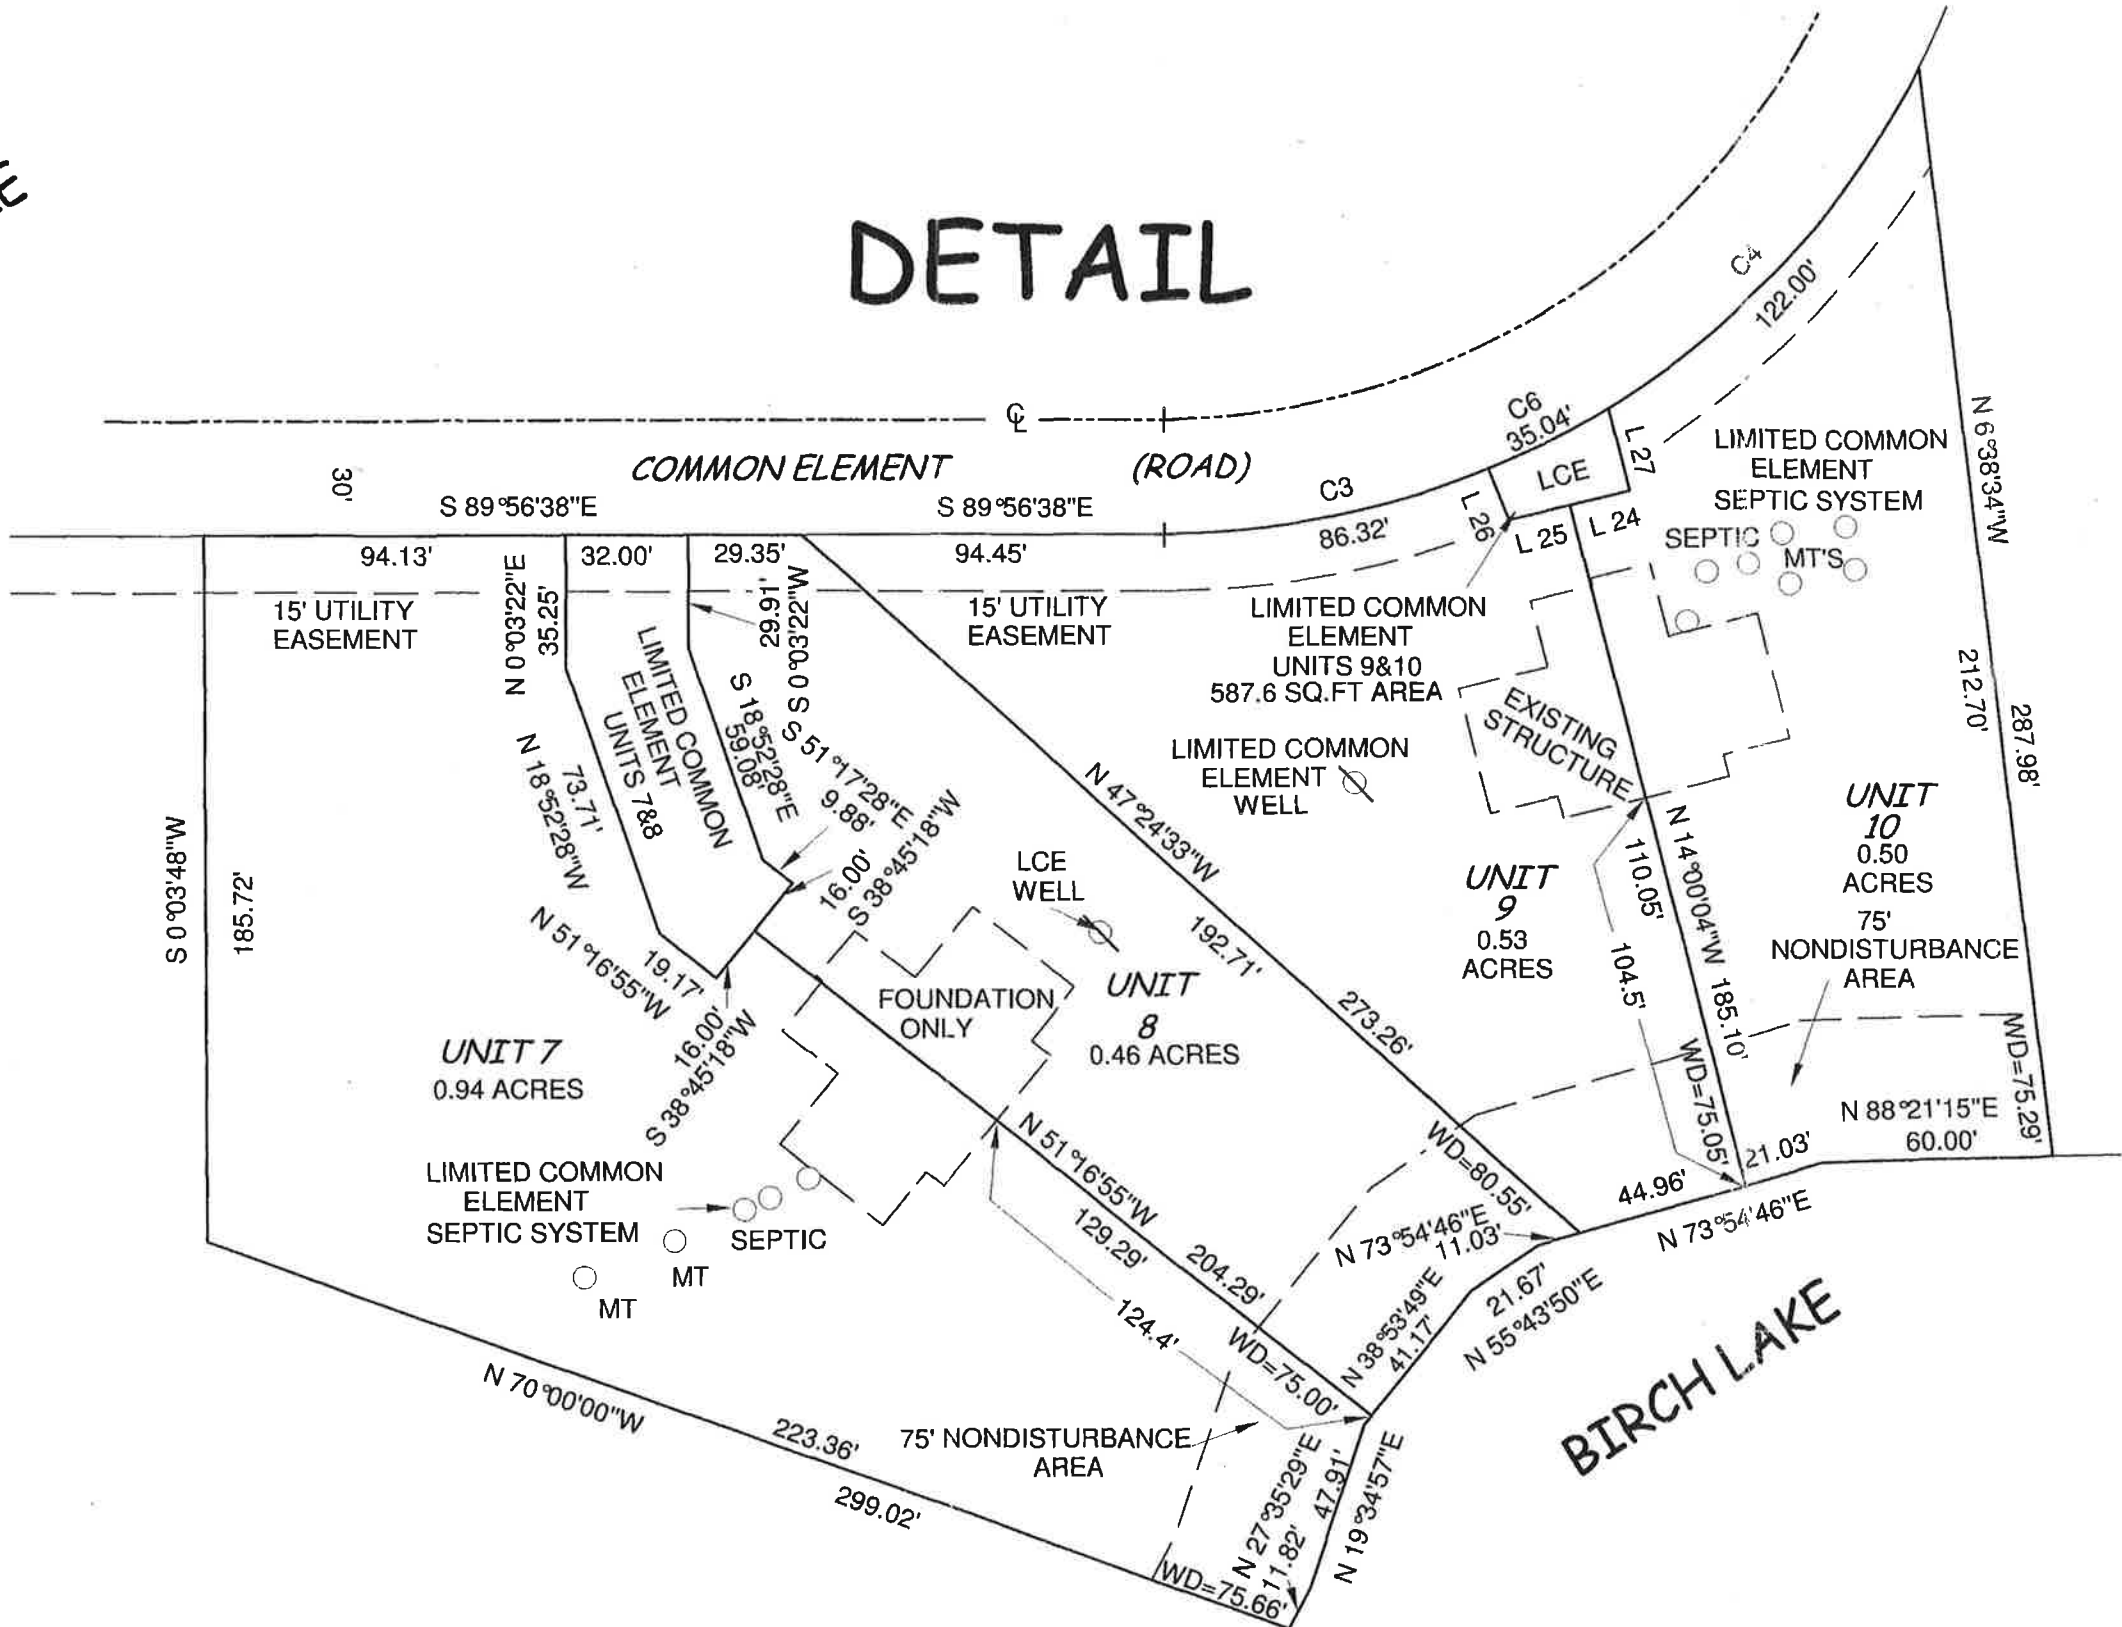

2016-117
Plat #
Palmer
 Rec Dist
8118 20.16
 Date
 Time **3:12 P M**

A SURVEY MAP OF
OASIS AT BIRCH LAKE
CONDOMINIUMS
PHASE 1
 UNITS 7-8-9-10
 LOCATED WITHIN
 W1/2 NW1/4 SE1/4
SECTION 15
 TOWNSHIP 21 NORTH, RANGE 5 WEST,
 SEWARD MERIDIAN ALASKA
 PALMER RECORDING DISTRICT
 CONTAINING 16.18 ACRES MORE OR LESS

PILCH LAND SURVEYING
 P.O. BOX 641 WILLOW, ALASKA 99688
 907-495-6611

DATE	DRAWN	FILE	SCALE	SHEET	OF
AUG 15, 2016	PPP	BIRCON7	1" = 100'	1	1