


ASBUILT SURVEY
 UNITS 5-6
 OASIS AT BIRCH LAKE CONDOMINIUMS
 PHASE 2

PILCH LAND SURVEYING P.O. BOX 641 WILLOW, ALASKA 99688

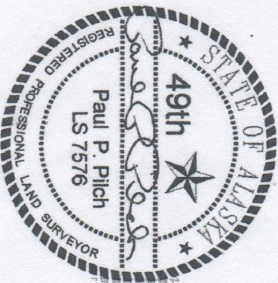

BIRCH LAKE